



WESTINGHOUSE, CHURCH, KERR & CO
ENGINEERS
6 & 10 BRIDGE ST. NEW YORK.

Drawn by R.E.
Checked by S.L.

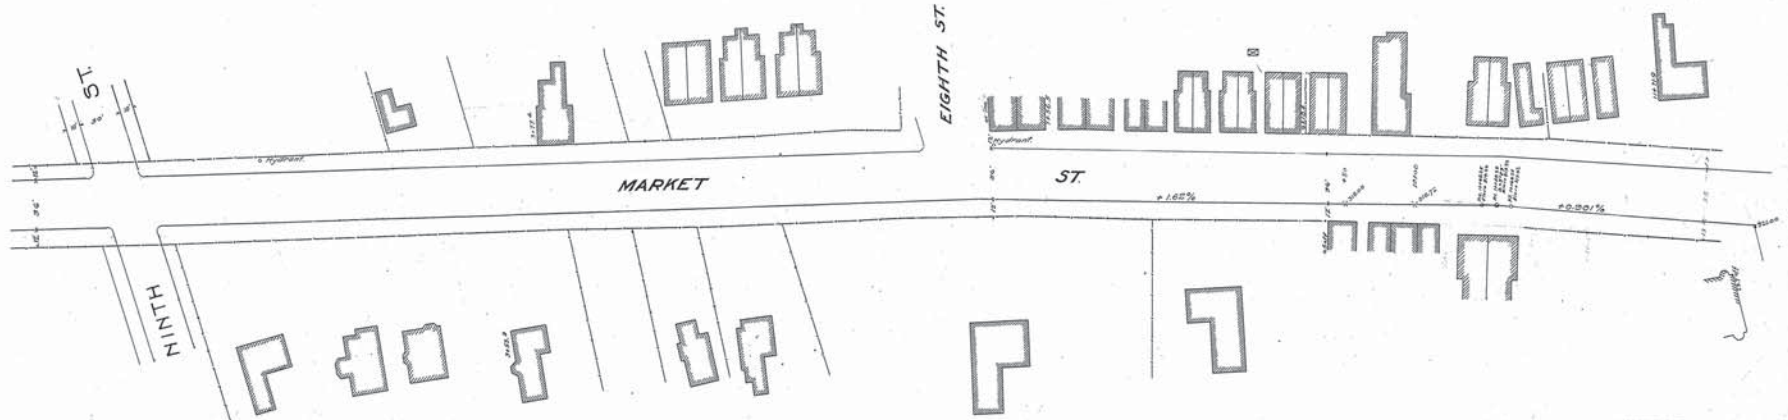

Note: The line shown in red and marked street line represents to the beyond which no buildings shall be built.
The grade line shown on profile is an average grade between curbs.

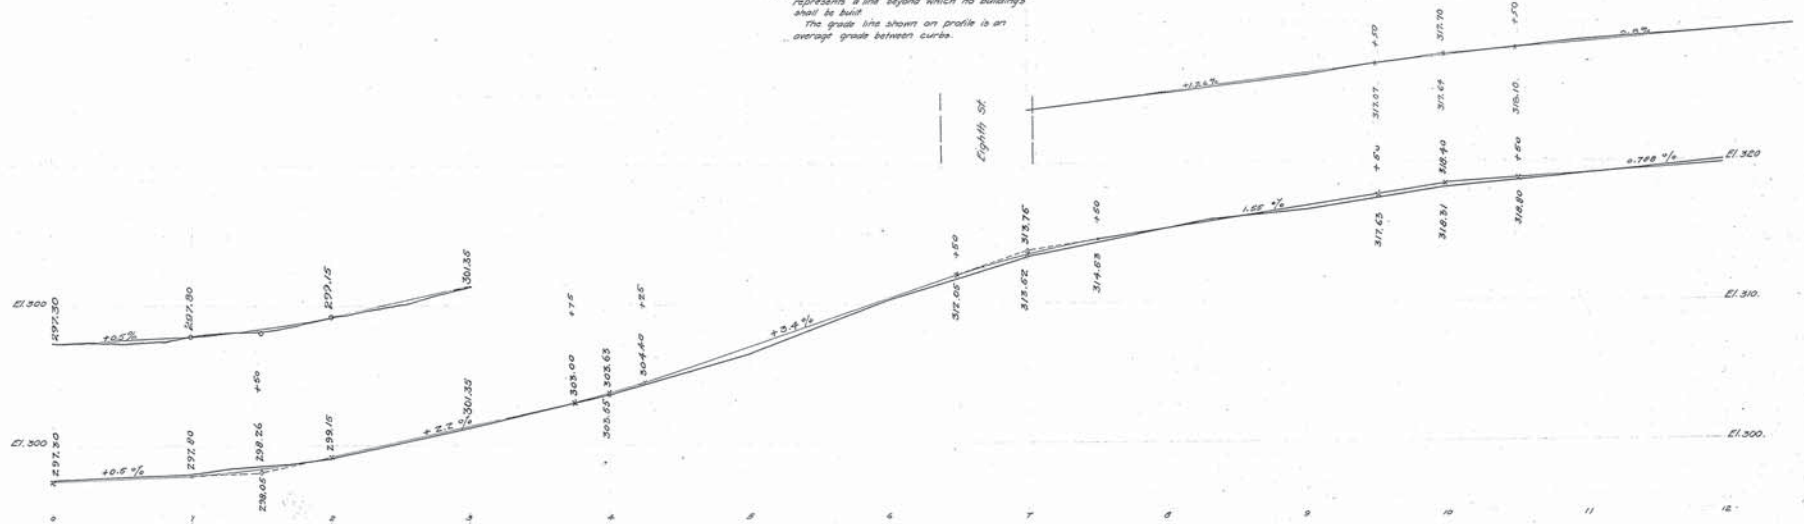

Adopted by The Mayor and Aldermen of Frederick
by ordinance passed and approved Dec. 3, 1907

Attest:
W. A. McCaffrey
City Registrar.



The Mayor and Aldermen of Frederick
By
Geo. Edw. Smith Mayor.

FREDERICK CITY
PLAN AND PROFILE OF MARKET STREET.
SHOWING ESTABLISHED GRADE AND STREET LINE.
Frederick Md.
Oct. 7, 1907.
Sheet 1 of 7 Sheets.
N. Y. No. 19657.

WESTINGHOUSE CHURCH, KERR & CO. 19857

MARKET STREET

WESTINGHOUSE, CHURCH, KERR & Co.
ENGINEERS
6 & 10 BRIDGE ST. NEW YORK.

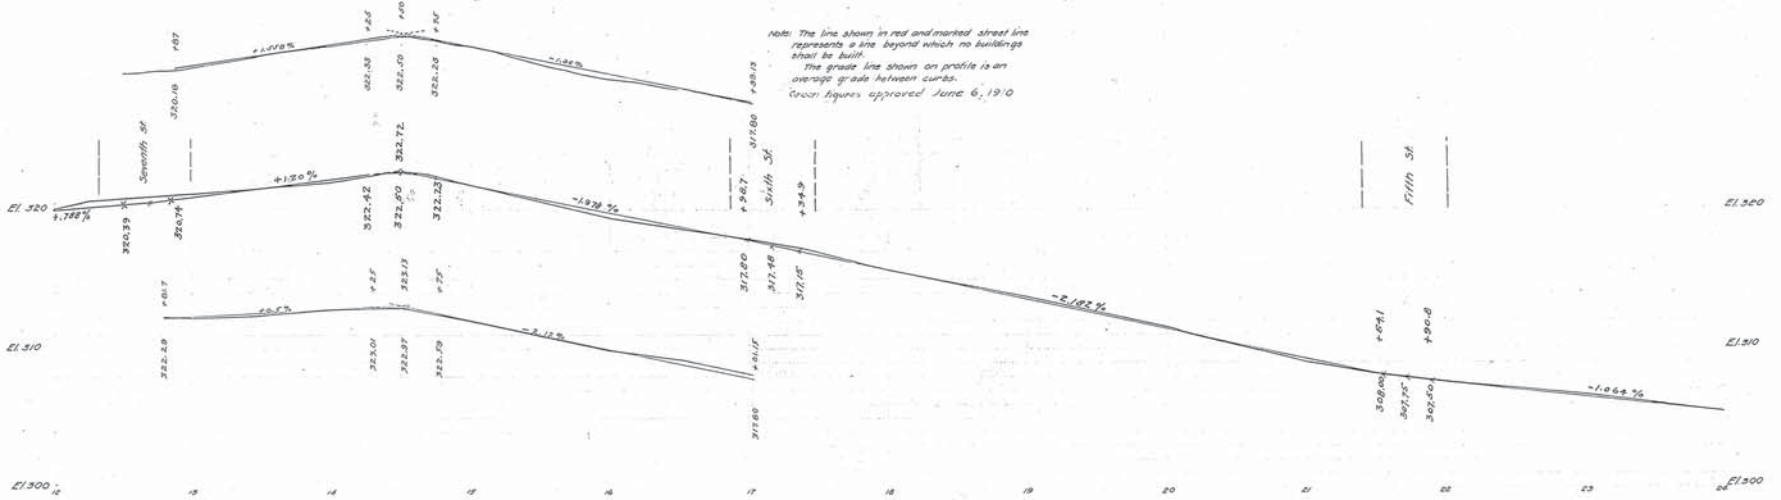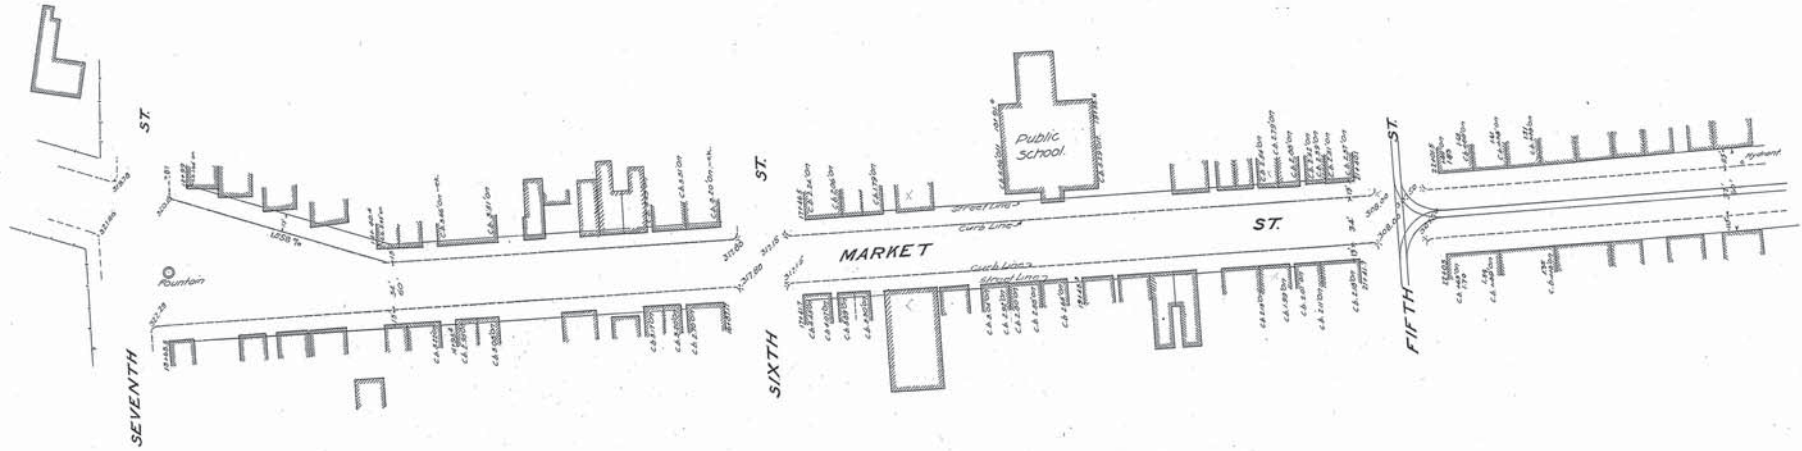

Note: The line shown in red and marked street line represents a line beyond which no buildings shall be built.
The grade line shown on profile is an average grade between curbs.
Green figures approved June 6, 1910

Repealed and reenacted by ordinance passed and approved June 6, 1910.

Adopted by The Mayor and Aldermen of Frederick, by ordinance passed and approved Dec. 3, 1909

Attest: *M.A. McGuffey*
City Registrar
The Mayor and Aldermen of Frederick
by *Geo. Edwin Smith*
Mayor


Attest: *M.A. McGuffey*
City Registrar
The Mayor and Aldermen of Frederick
by *Geo. Edwin Smith*
Mayor

FREDERICK CITY
PLAN & PROFILE OF MARKET STREET.
SHOWING ESTABLISHED GRADE & STREET LINE
Frederick Md.
Oct. 7 1907
Sheet 2 of 7 Sheets.


WESTINGHOUSE CHURCH, KERR & CO. 19858

MARKET STREET

WESTINGHOUSE, CHURCH, KERR & Co.
ENGINEERS
6 & 10 BRIDGE ST. NEW YORK

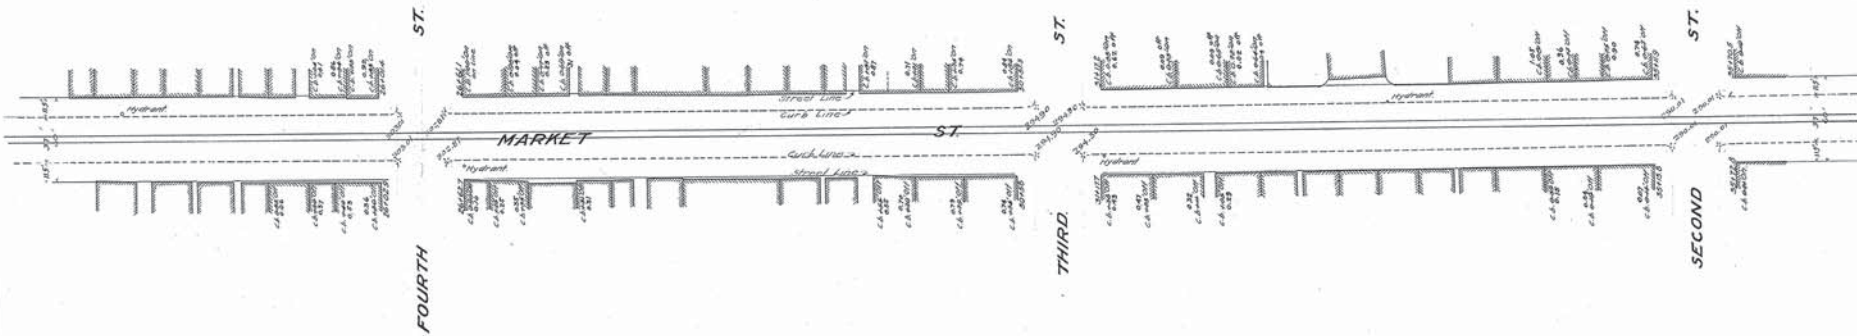

Note: The line shown in red and marked street line represents a line beyond which no buildings shall be built.
The grade line shown on profile is an average grade between curbs.
elevation figures approved June 6, 1910

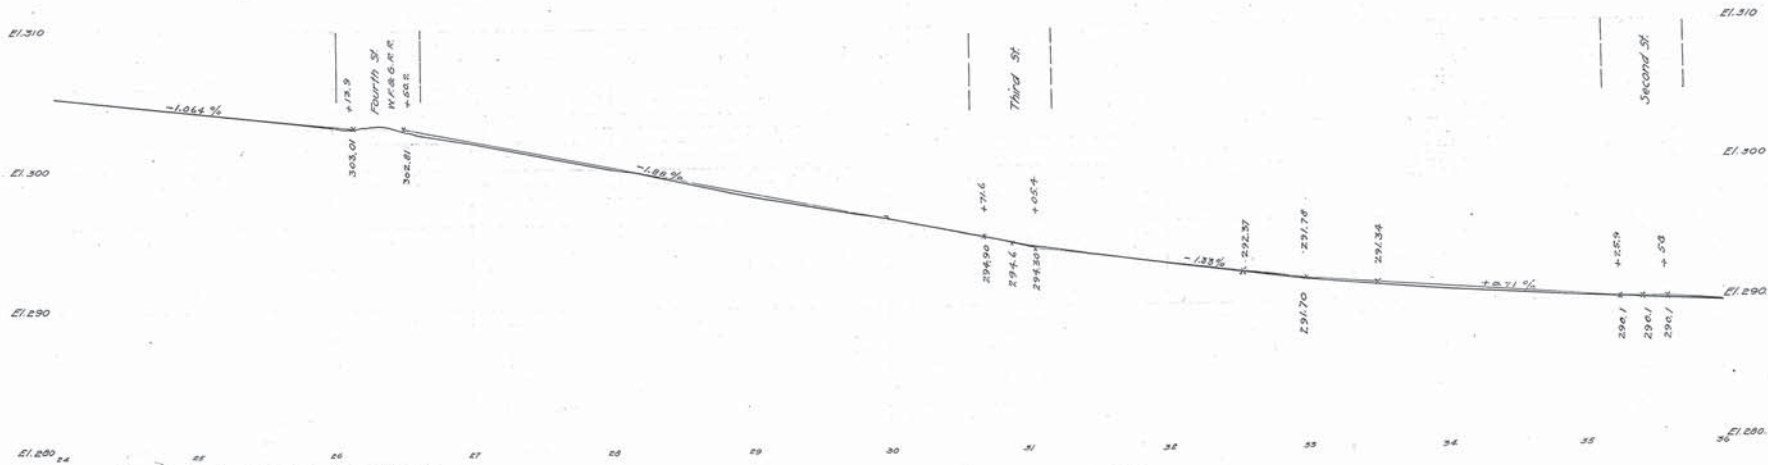

Repealed and reconnected by ordinance passed and approved June 6, 1910

Adopted by The Mayor and Aldermen of Frederick, by ordinance passed and approved Dec. 3, 1909

Attest
W. A. McCaffrey
City Registrar

The Mayor and Aldermen of Frederick
By *Geo. Edwin Smith*
Mayor

Attest
W. A. McCaffrey
City Registrar


The Mayor and Aldermen of Frederick
By *Geo. Edwin Smith* Mayor.

FREDERICK CITY
PLAN & PROFILE OF MARKET STREET
SHOWING ESTABLISHED GRADE & STREET LINE
Frederick Md. Oct 7, 1907
Scale 1" = 40' Hor. 1" = 4' Vert.
Sheet 3 of 7 Sheets.

N. Y. No. 19859.

WESTINGHOUSE, CHURCH, KERR Co.
ENGINEERS
6 & 10 BRIDGE ST. NEW YORK.

Drawn by *RF*
Checked by *MM*

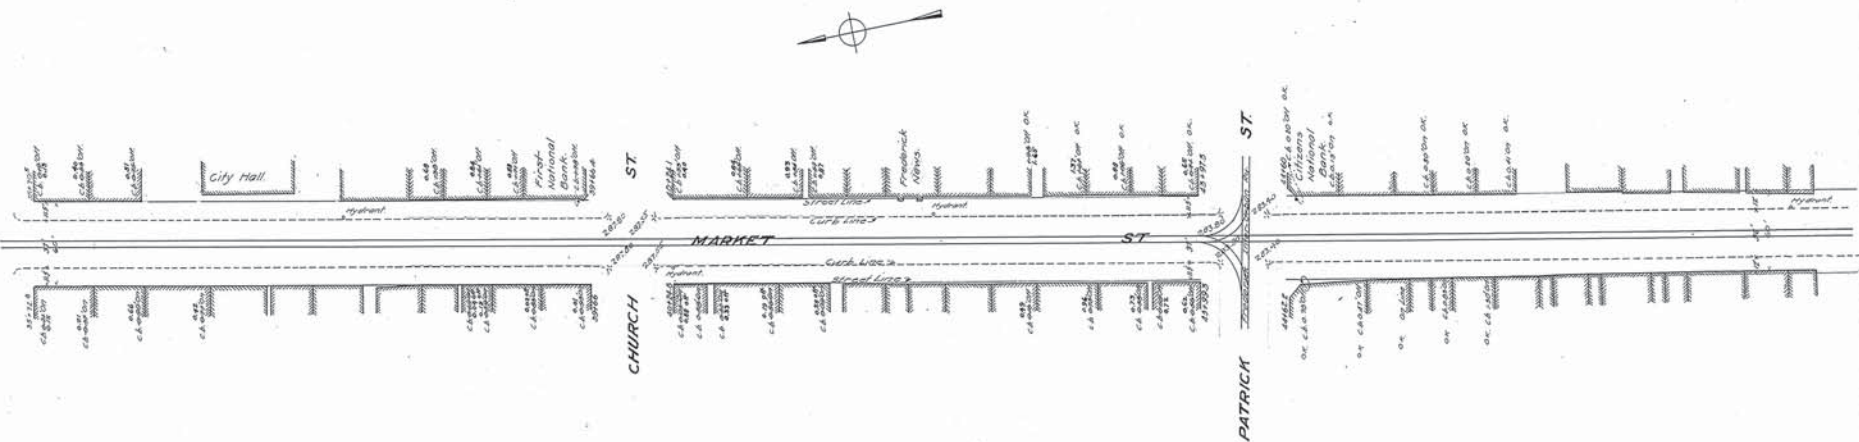

Note: The line shown in red and marked street line represents a line beyond which no buildings shall be built.
The grade line shown on profile is an average grade between curbs.
Elevations approved June 6, 1910



Repealed and reenacted by ordinance passed and approved June 6, 1910

Adopted by The Mayor and Aldermen of Frederick, by ordinance passed and approved Dec. 3, 1909.

Attest
M. A. McCaffrey
City Registrar

The Mayor and Aldermen of Frederick
by *Geo. Edwin Smith*
Mayor

Attest:
M. A. McCaffrey
City Registrar

The Mayor and Aldermen of Frederick
BY *Geo. Edwin Smith* Mayor.

FREDERICK CITY
PLAN & PROFILE OF MARKET STREET.
SHOWING ESTABLISHED GRADE & STREET LINE.
Scales 1" = 40' Vert. 1" = 40' Hor.
Frederick Md. Oct. 8 1907
Sheet 4 of 7 Sheets
N. Y. No. 19860.


MARKET STREET

WESTINGHOUSE CHURCH, KERR & CO.


19860

Drawn by *AG*
Checked by *PK*

WESTINGHOUSE, CHURCH, KERR & Co.
ENGINEERS.
6 & 10 BRIDGE ST. NEW YORK.

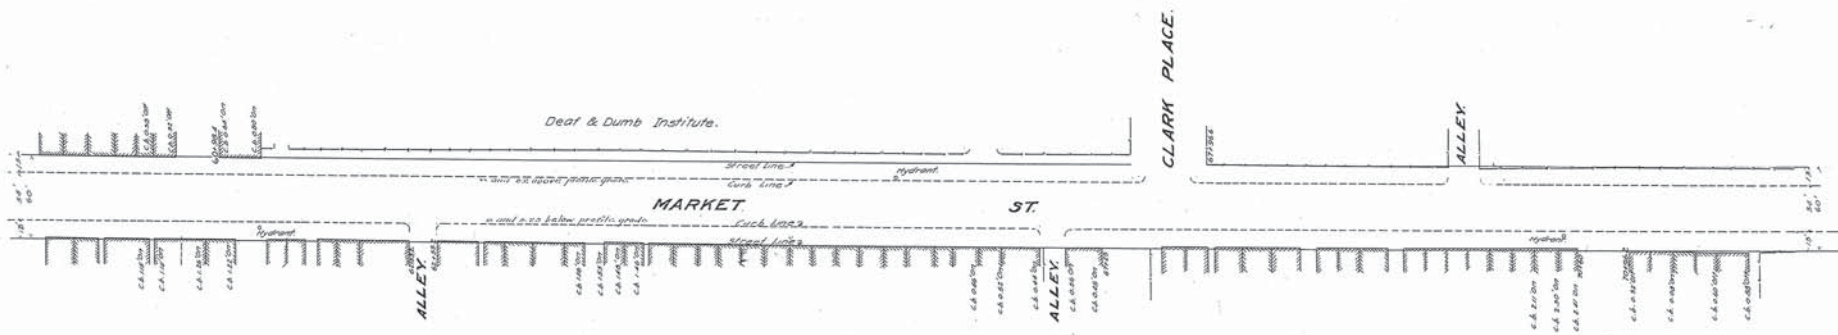

Note: The line shown in red and marked street line represents a line beyond which no buildings shall be built.
The grade line shown on profile is an average grade between curbs.

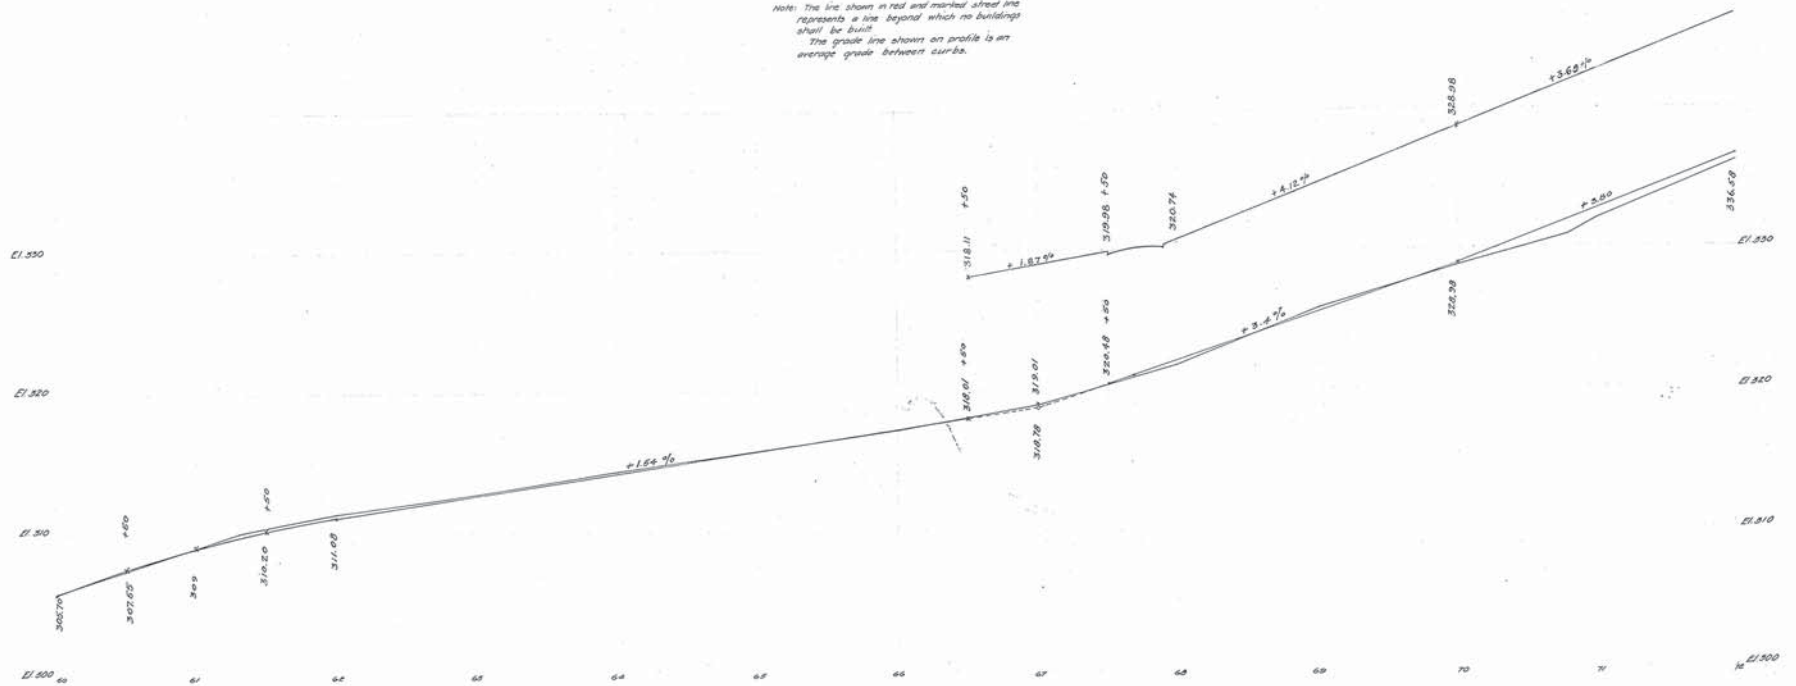

Adopted by The Mayor and Aldermen of Frederick
by ordinance passed and approved Dec. 3, 1909.

Attest: *M. A. McCaffrey*
City Registrar.

Edw. H. Mayor
The Mayor and Aldermen of Frederick.

FREDERICK CITY
PLAN & PROFILE OF MARKET STREET.
SHOWING ESTABLISHED GRADE & STREET LINE.
Frederick Md. Oct. 6 1907.
Sheet 6 of 7 Sheets.
N. Y. No. 19862.



19862
WESTINGHOUSE CHURCH, KERR & CO.

MARKET STREET

P. 6-P. 1

WESTINGHOUSE, CHURCH KERR & Co.
ENGINEERS
6 & 10 BRIDGE ST. NEW YORK.

Drawn by *W.C.*
Checked by *J.H.* (7)

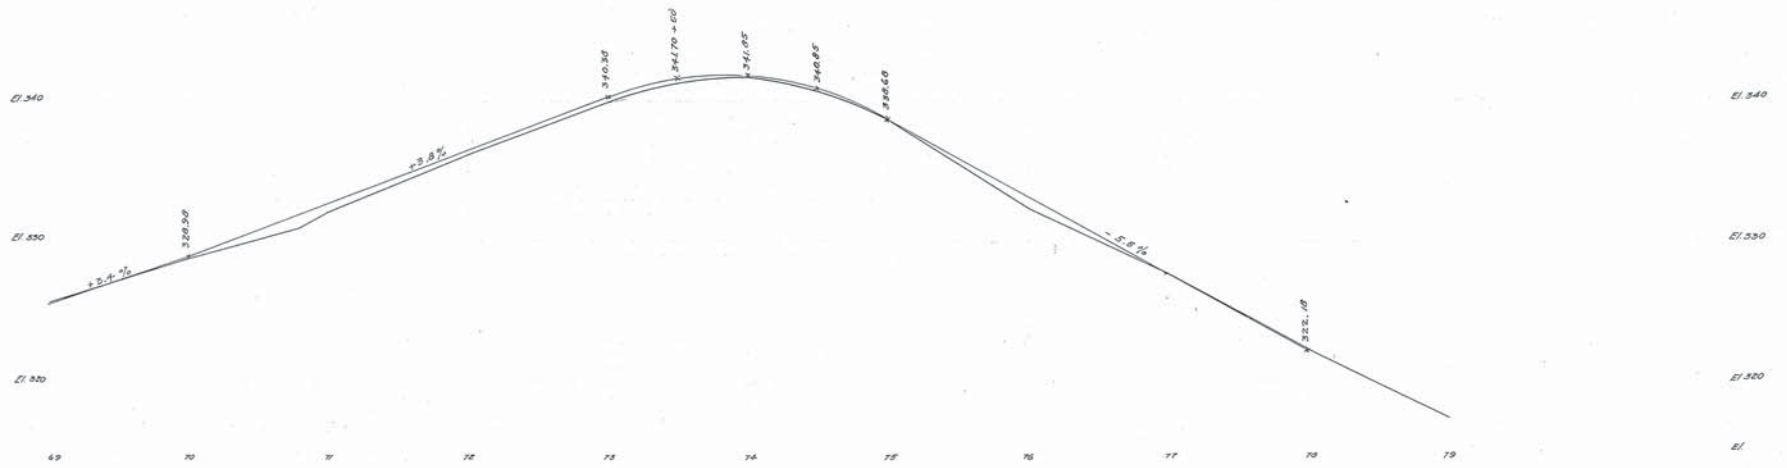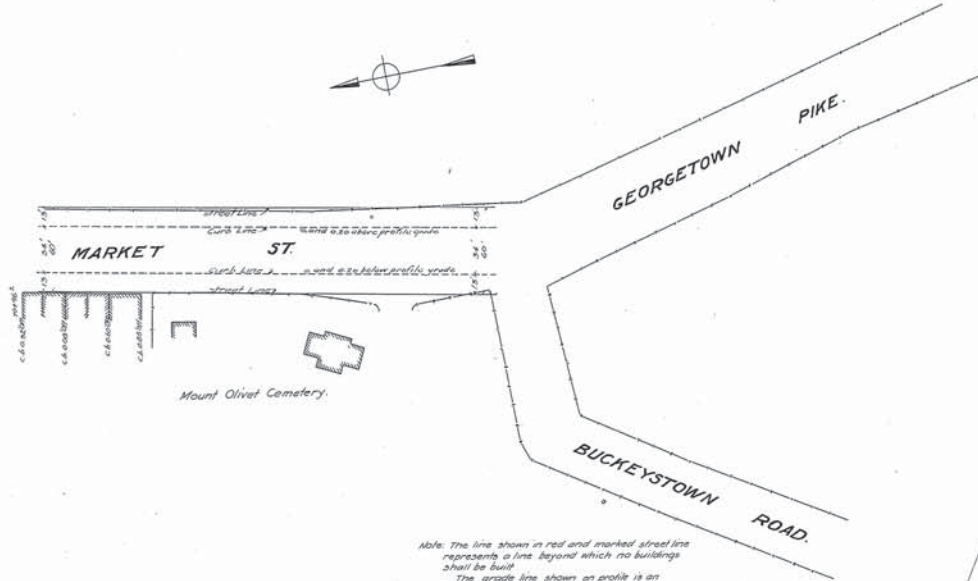

Adopted by The Mayor and Aldermen of Frederick
by ordinance passed and approved Dec. 3, 1909

Attest:
W. U. McCaffrey
City Registrar

The Mayor and Aldermen of Frederick
By *Geo. Edwin Smith* Mayor

FREDERICK CITY
PLAN & PROFILE OF MARKET STREET.
SHOWING ESTABLISHED GRADE AND STREET LINE.
Scales: 1" = 40' Vert., 1" = 40' Hor.
Frederick Md. Oct 8 1907.
Sheet 7 of 7 Sheets.

N. Y. No 19863

P. 6-F. 1

WESTINGHOUSE CHURCH, KERR & CO.
19863